


- NOTES:
- THIS DRAWING WAS COMPILED FROM INFORMATION PROVIDED BY WANZEK, UTILIZING INFORMATION FROM THE FOLLOWING FILE LIST.
 - CRM_AvoidanceBuffer_110813.SHX
 - USFWS_WetEase_1012.SHX
 - Wetlands_Poly_102314.SHX
 - Courtenay_TurbineArrayRenumbering_2015_07_15.SHX
 - Courtenay ALTA 150120.DWG
 - Courtenay_CollectionRecordLines_20161108.SHP
 - Courtenay_AdditionalSurveyCorridor_2015_10_07.kmz
 - THE AERIAL WAS OBTAINED BY ULTEIG.
 - CourtenayAerial_NDStateplane_HarrNAD83_South_IntFt.SID

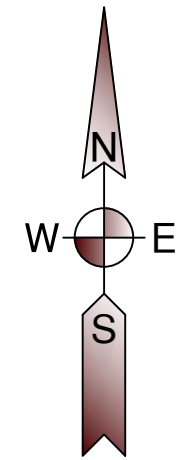

RECORD DRAWING
DRAWINGS ARE BASED UPON
CONSTRUCTION CONTRACTOR REDLINES
WHICH HAVE NOT BEEN FIELD VERIFIED BY
ENGINEER OF RECORD.

LEGEND

- XX WIND TURBINE
- F1 FEEDER 1
- F2 FEEDER 2
- F3 FEEDER 3
- F4 FEEDER 4
- F5 FEEDER 5
- F6 FEEDER 6
- F7 FEEDER 7
- F8 FEEDER 8
- FOC FIBER ROUTE
- SURVEYED CORRIDORS
- RIGHT OF WAY
- NON LEASED
- XJBX JUNCTION BOX
- SPLX-X CABLE SPLICE
- FSX-X FIBER SPLICE
- GRDX-X MID SPAN GROUND
- ACCESS ROADS
- BORE LOCATION [RB X-X]

NO	REVISION	ZONE	DATE	BY	CHK	ENG	NO	REVISION	ZONE	DATE	BY	CHK	ENG	REFERENCE DRAWINGS			
A	90% SUBMITTAL		10/12/2015	MJ	JH	BG									DWG NO.	MANUFACTURER	DESCRIPTION
0	ISSUED FOR CONSTRUCTION		01/22/2016	AS	JH	BG											
1	REVISED KEY MAP		02/10/2016	CL	JH	BG											
2	UPDATED CORRIDORS		06/07/2016	BG	JH	BG											
3	RECORD DRAWING		12/05/2016	GP	JH	BG											

XcelEnergy
NORTHERN STATES POWER
COURTENAY WIND - COLLECTION SYSTEM
STUTSMAN COUNTY, NORTH DAKOTA

DWN: MJ	DATE:01/22/2016	CHK:	DATE:
ENG: BG	DATE:01/22/2016	CHK:	DATE:
PM: BD	DATE:01/22/2016	PROJ. NO: 121901101	
APVD:	DATE:	SCALE:NONE	

THIS MAP/DOCUMENT IS A TOOL TO ASSIST EMPLOYEES IN THE PERFORMANCE OF THEIR JOBS. YOUR PERSONAL SAFETY IS PROVIDED FOR BY USING SAFETY PRACTICES, PROCEDURES, AND EQUIPMENT AS DESCRIBED IN THE SAFETY TRAINING PROGRAMS AND MANUALS.

ENERGY SUPPLY
ENGINEERING & CONSTRUCTION

UNIT 0

FEEDER ROUTING DIAGRAM
SECTION 20, T143N, R62W

NH-271536-34

REV
3